


NORTHLAKE CENTRE

3255 W. Pioneer Parkway, Pantego, Texas

SUITE 3255
6,640 SF

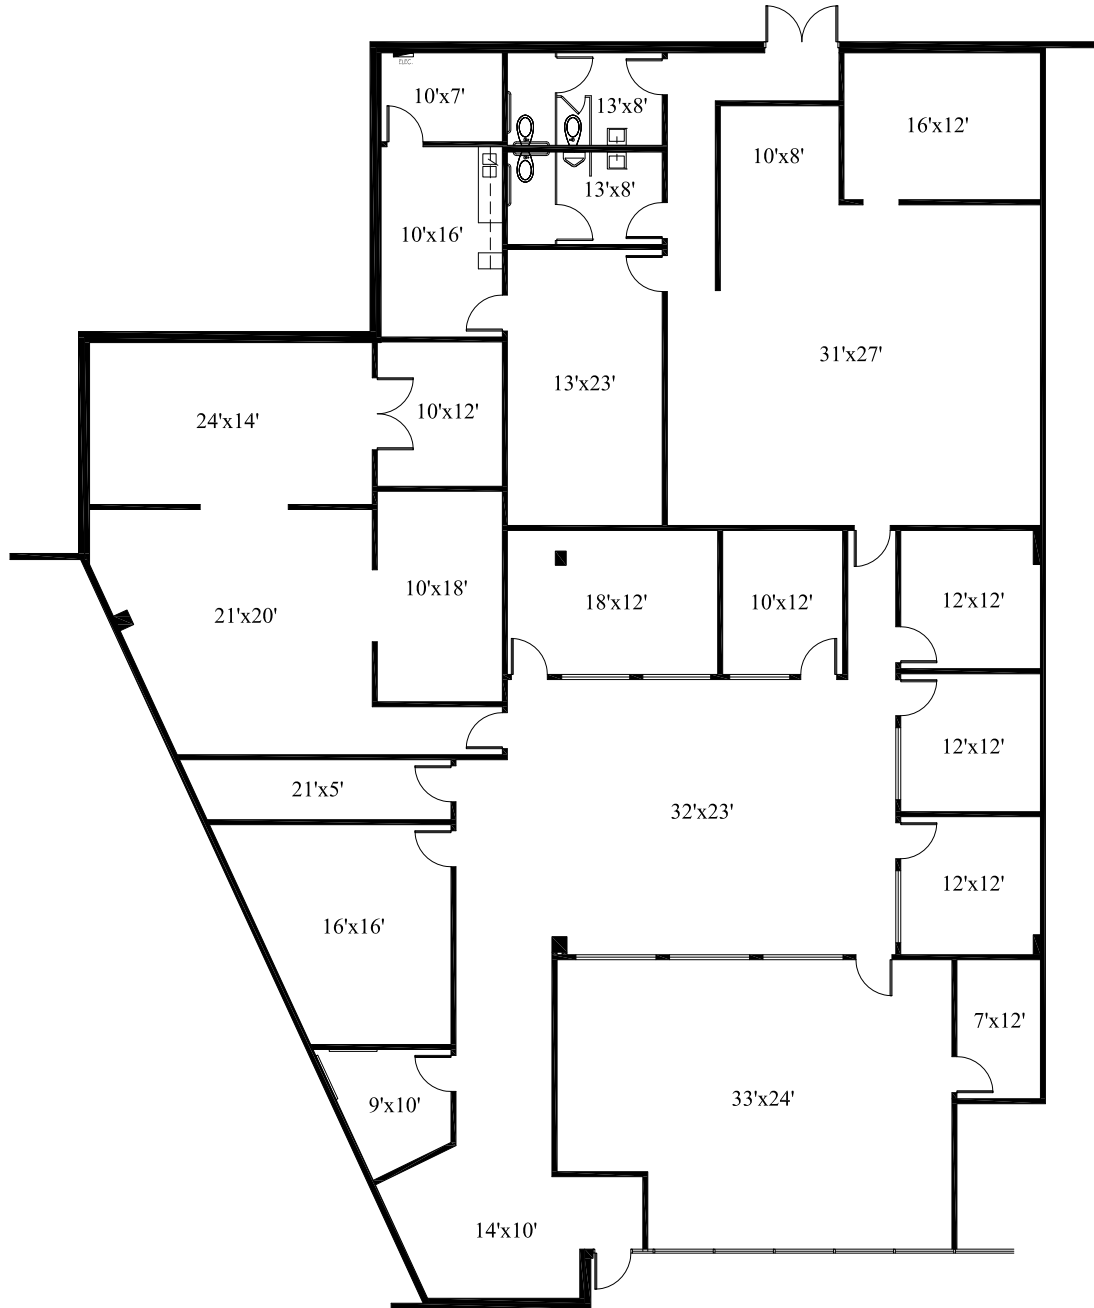

1ST FLOOR

Scale: 1/16"=1'-0"

All dimensions and square footages are approximate.

September 15, 2021



THOMPSON CONSULTING SERVICES, INC.

12024 Golden Meadow Lane, Forney, Texas 75126 (972)564-5252