
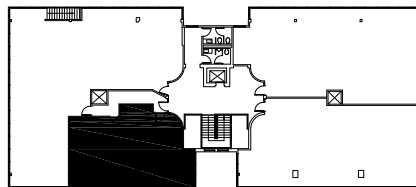


# ONE BROADWAY PLACE

2910 Broadway Blvd., Garland, Texas

SUITE 201  
1,174 RSF

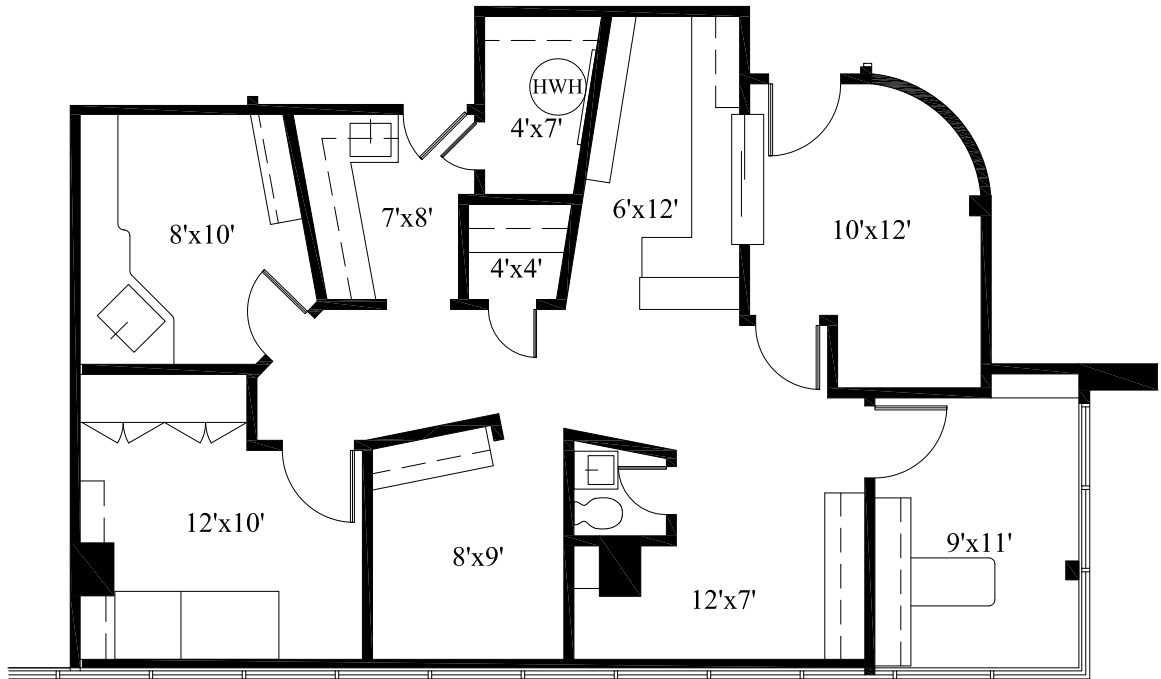

## 2ND FLOOR

Scale: 1/8"=1'-0"

All dimensions and square footages are approximate.

April 14, 2021



THOMPSON CONSULTING SERVICES, INC.

12024 Golden Meadow Lane, Forney, Texas 75126 (972)564-5252